ATTACHMENT A - NORTH LOBBY EXHIBIT

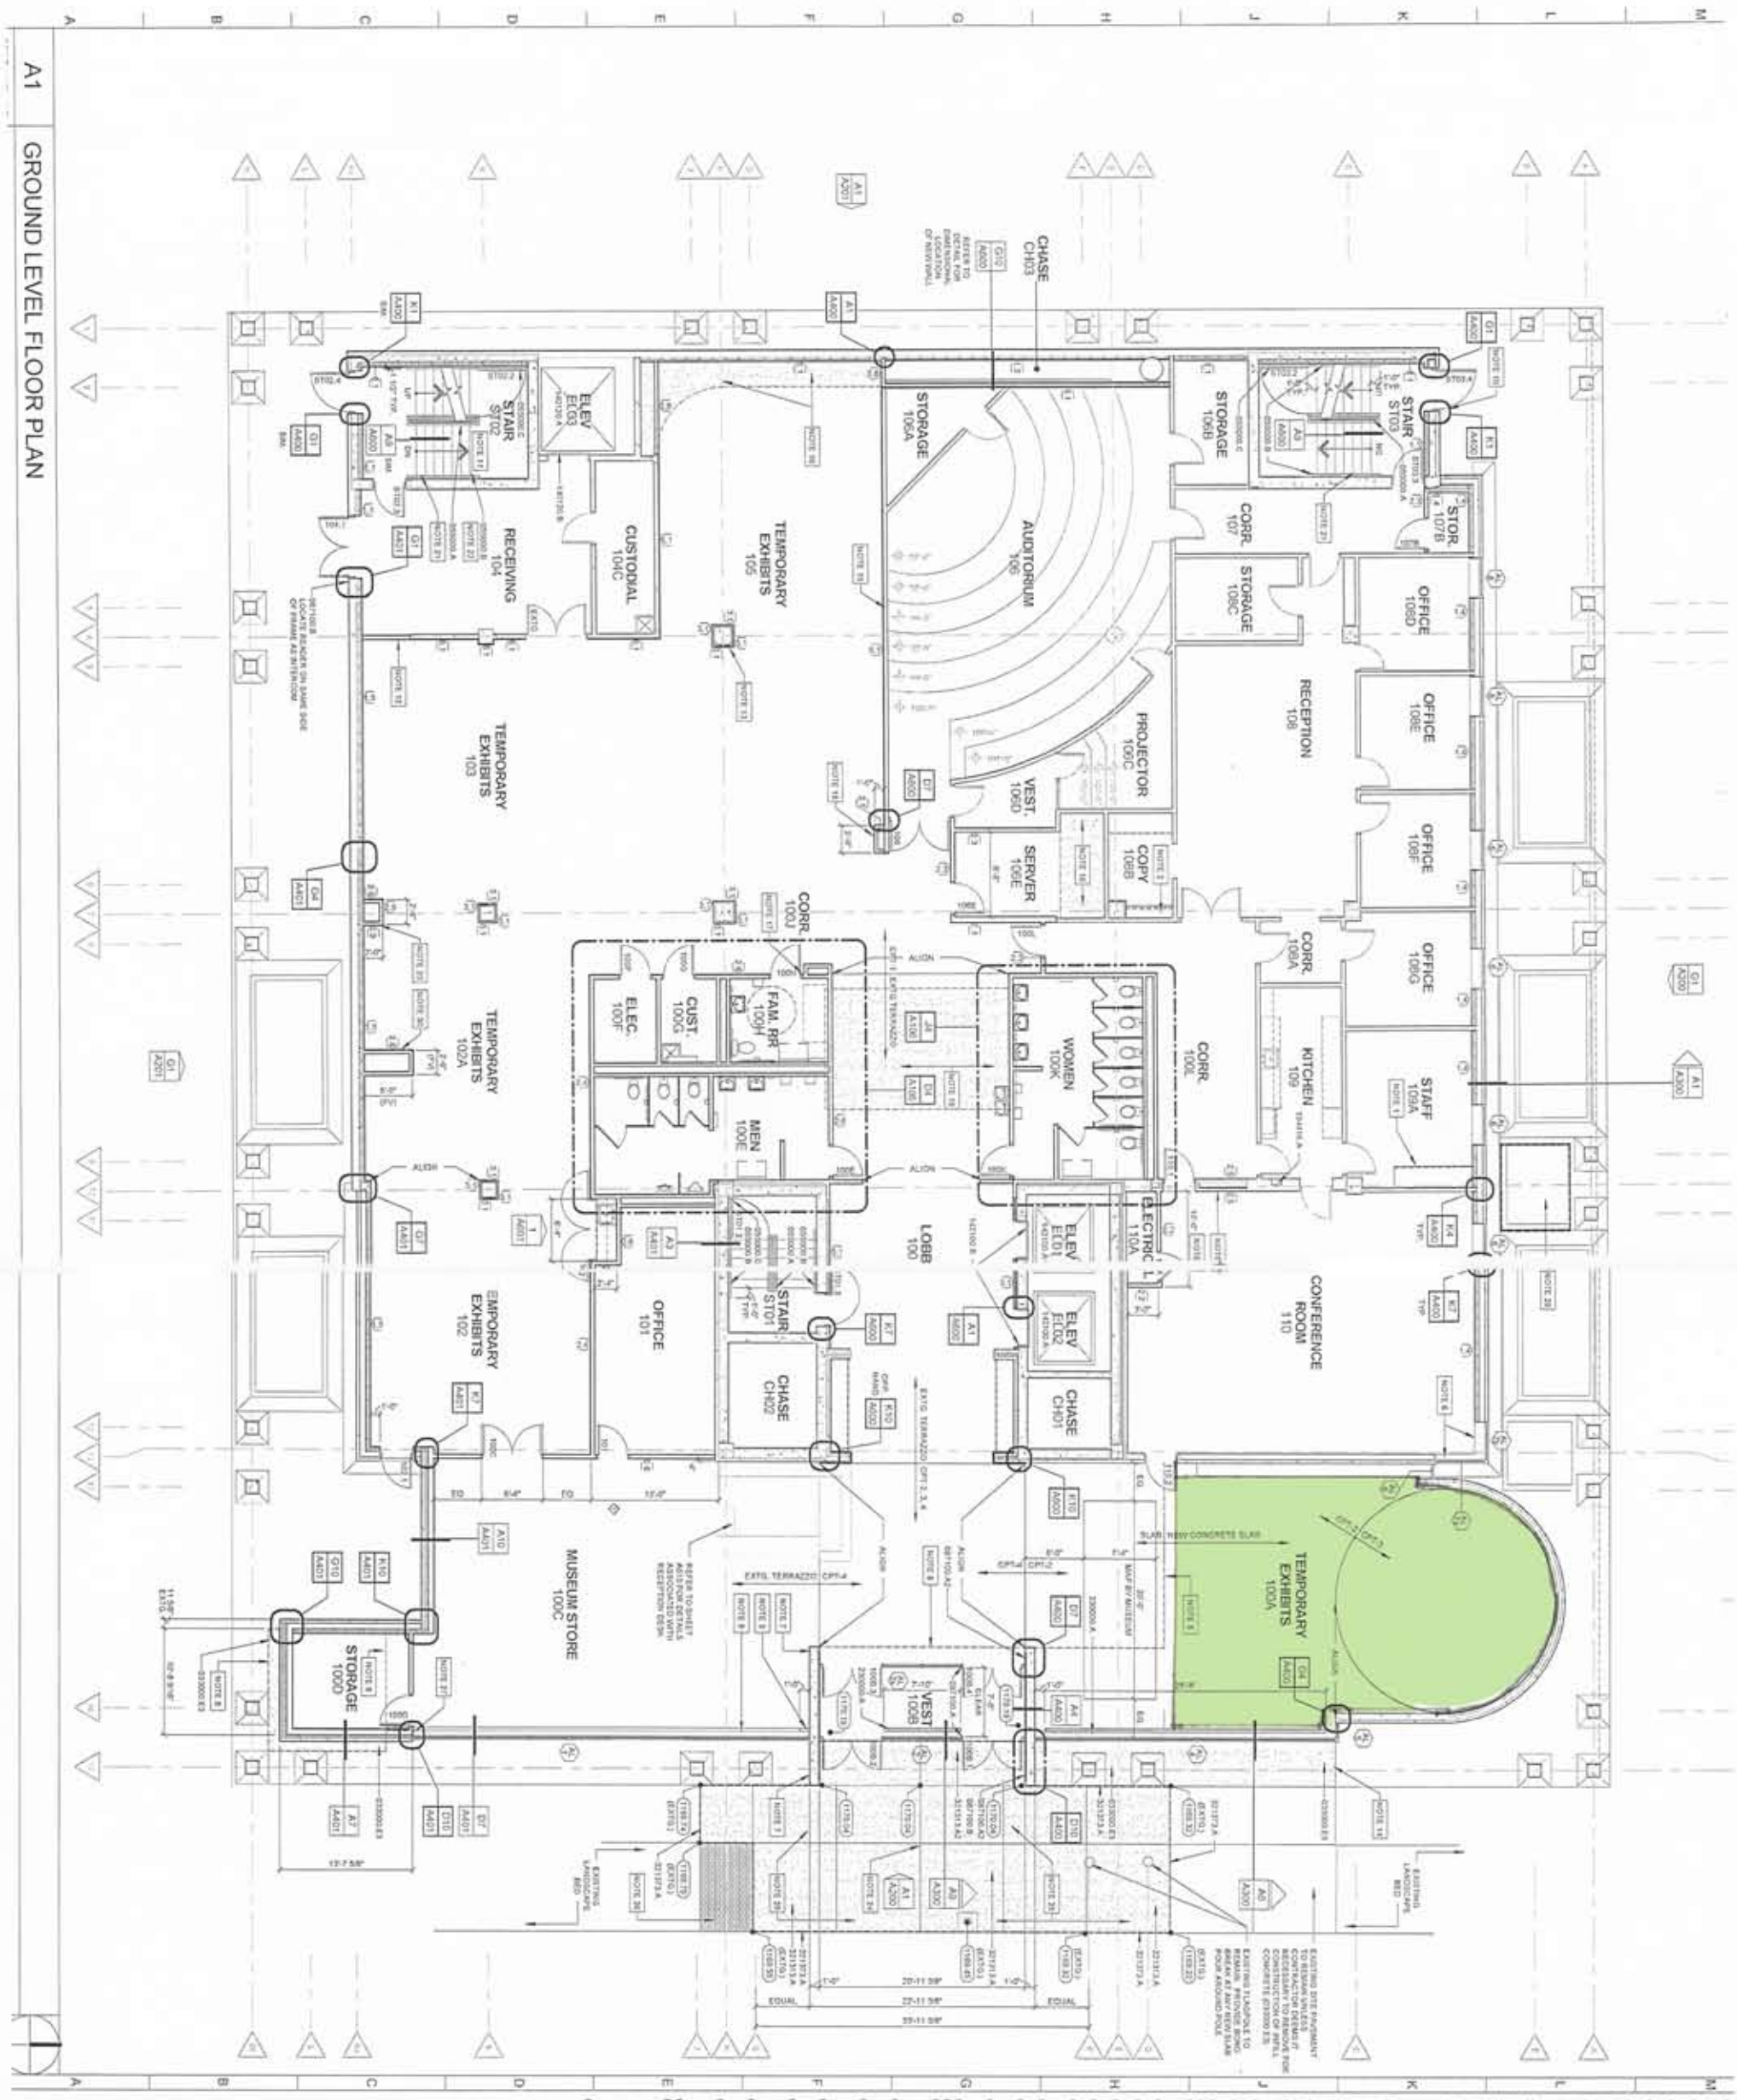

IN PROGRESS ARCHITECTURAL RECORD DRAWING

ISSUED TO INCORPORATE CHANGES MADE DURING PRIVATE DESIGN AND CONSTRUCTION PROCESS. ITEMS IDENTIFIED BY OWNER OR CONTRACTOR AND THEREFORE CANNOT BE SUBSTANTIATED BY THE DESIGN PROFESSIONALS AS TO THEIR ACCURACY.

KEYNOTE LEGEND

SHEET A101 SHEET SPECIFIC NOTES

SINCLAIR hille architects
700 O St. Lincoln, NE 68508
T: 402 476 7331

ALLEY-POYNER MACCHIETTO ARCHITECTURE
1516 Cuming Street
Omaha, NE 68102
Ph: 402.341.1444
Fx: 402.341.4733
alleypoyner.com

BVA PROJECT No. 13059

A101

Ground Level Floor Plan

Nebraska History Museum Renovation

PROJECT CONSULTANTS

STRUCTURAL ENGINEER
R.O. Youker Inc.
1201 O Street, Suite 310
Lincoln, NE 68508
402 477 7640

MECHANICAL / ELECTRICAL ENGINEER
Morrissey Engineering Inc.
4040 North 118th Street
Omaha, NE 68164
402.491.4144

This document originally issued and sealed by:
David E. Guade
Registered Professional Architect A-3466
On: 08.20.14

DESIGN ARCHITECT: MA	REVISIONS
PROJECT ARCHITECT: DEQ	
DRAWN BY: DEQ	
ISSUED: July 23, 2014	